



**Rivercourt Engineering Inc.**

4 Beechwood Cres., Toronto ON M4K 2K8

tel 647-479-4104; info@rivercourt.ca

[www.rivercourt.ca](http://www.rivercourt.ca)

February 3, 2025

**RE: Septic system design for Commisso Estate Winery located at 564 Kemp Road E., Grimsby, ON**

---

Rivercourt Engineering designed a septic system with a capacity of 4,620 L/d. The system was designed to service the new winery building and the existing garage to the east of the main residence that was also connected to the new septic system. The existing garage currently has a retail space with bathrooms that are accessible for the retail customers. However, once the new winery building is complete, the garage will no longer be used for retail or accessed by winery guests.

A septic permit was obtained from the Niagara Region in September 2020 and later revised in October 2022. The permit number is L126/20 and is included with this document. The septic system was installed in December 2022. It includes a septic tank, pump tanks, a constructed wetland (Aqua Wetland System) for treatment, and a raised Type A dispersal bed for disposal of the treated effluent.

Since the 2022 permit, the occupancy plans for the winery building have changed, but the overall design flow has not increased, and therefore, the septic system is suitably designed and permitted to service the winery building. The main change to the plans is that the garage and its bathrooms will no longer be used as everything will occur in the winery building. Previously, the winery building was presumed to be more production focused but now there will also be retail and hospitality. To account for the change, the following table shows an updated design flow calculation as per Table 8.2.1.3.B of the Ontario Building Code (OBC):

	unit	# units	L/d per	L/d
Employee (production)	8 h shift	2	75	150
Retail floor area (19.8 m <sup>2</sup> )	9.25 m <sup>2</sup>	3	40	120
Water closets (for retail)	WCs	1	950	950
Hospitality (wine tasting)	Seats	30	36	1,080
Total				2,300

The wastewater design flow from the wine production remains unchanged at 2,250 L/d. Based on an annual production goal of 8,000 cases of wine per year.

**The total design flow is 2,300 L/d + 2,250 L/d = 4,450 L/d. Rounded up to 4,620 L/d.**

The total design flow for the property:

Source	Flow (L/d)	Septic System
Main residence (5-bdr)	2,800	<i>Existing</i>
Second residence (3-bdr)	1,600	<i>Existing</i>
Winery	4,620	<i>New</i>
<b>TOTAL</b>	<b>9,020</b>	


The septic permit attached to this document includes the design drawings from October 2022. There were some minor changes to the layout of the septic system, which will be reflected in as-built drawings. The updated layout drawing is also attached to this document.

**In summary, the septic system has the capacity to service the new winery building.**

Sincerely,

Andrew Hellebust, P.Eng.  
President, Rivercourt Engineering Inc.



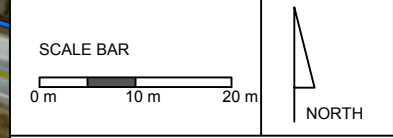

PROJECT:  
**VILLA BACCHUS**  
 564 Kemp Rd. East. Grimsby, ON  
 DESIGN OF SEWAGE WORKS

**Rivercourt**  
 Rivercourt Engineering Inc.  
 4 Beechwood Crescent  
 Toronto ON M4K 2K8  
 Tel. 647-479-4104  
 www.rivercourt.ca

**TREATMENT TECHNOLOGIES**  
 THE AQUA WETLAND SYSTEM  
 AQUA Treatment Technologies Inc.  
 4250 Fly Rd. Campden ON L0R 1G0  
 905-327-4571  
 www.aqua-tt.com

NO.	AS-BUILT	DATE: Feb. 3, 2025	DRAWN: ER	CHECKED: AH
NO.	UPDATED DESIGN - ISSUED FOR NIAGARA REGION REVIEW	DATE: Oct. 19, 2022	DRAWN: ER	CHECKED: AH
NO.	ISSUED FOR SEPTIC PERMIT APPLICATION	DATE: Jul. 15, 2020	DRAWN: ER	CHECKED: AH

REVISIONS	
REVISION	DRAWING NUMBER
C	REI-C01

REVISED - Oct. 2022

EXPIRY - Dec. 1, 2022.

FOR OFFICE USE ONLY

PERMIT #: L126/20

PERMIT VALID FOR ONE YEAR

RECEIPT #: R8290 (\$1100)

DATE OF RECEIPT: July 20/20

PERMIT TO CONSTRUCT OR DEMOLISH

FOR CONSTRUCTION OR ALTERATION OF A SEWAGE SYSTEM IN Grimsby MUNICIPALITY

Name of Applicant: FRANK COMMISSO Telephone #: (905) 605-1560

Mailing Address: 564 KEMP RD. EAST BEANSVILLE ON LOR 1B2

Location of Sewage Disposal Unit: 564 KEMP RD. EAST, Grimsby, Municipality

Building Type: RETAIL WINE BLDG. (EMPLOYEE-1) STORAGE BLDG. (EMPLOYEES-3 + WINE PROCESSING) Size: APPROX 20.0 M2 (RETAIL) 4620 Litres Per. Day

TANK SIZE Specifications for a Class 4 or 5 Sewage System

Litres: 15,000 Gallons: -

TYPE OF SYSTEM: RAISED TYPE 'A' w AWS PRETREATMENT (SEE REPORT) Minimum area of stone 69.7 92.4 m2 or - metres in a - metre wide trench

Conditions of Approval and Reason (e.g. fill, grading, drainage improvements, design sewage flows) X

SEE CONDITIONS ATTACHED

Note: information provided that lots have merged

CERTIFICATE OF ISSUANCE

Application approved and this Certificate of Issuance under the Building Code Act, S.O. 1992 and O.Reg. 22/98 is hereby issued for the proposal outlined on the application and its attachments as amended by the requirements and conditions provided that the sewage system shall be completed and an Occupancy Permit issued within 12 months of the issue hereof or such extended period as the Chief Building Official on application allows.

DO NOT OPERATE THE SYSTEM UNTIL A FINAL INSPECTION HAS BEEN CONDUCTED AND APPROVED.


Inspected by: [Signature] Inspector Date: Sept 01/20

Issued by: [Signature] for Phil Lambert Chief Building Official Date: Sept 1 2020

Mailed Copies: SEP 02 2020 OCT 20 2022 (a) Owner (b) Municipality (c) Contractor

**INSPECTOR'S REPORT ON INSTALLATION**

- a) Septic Tank/Holding Tank working capacity of \_\_\_\_\_ litres, constructed of Concrete  or Plastic   
 to serve: \_\_\_\_\_ (# of bedrooms) or \_\_\_\_\_  
 Installer's Name: \_\_\_\_\_ Installer's Address: \_\_\_\_\_  
 Tank Manufacturer: \_\_\_\_\_
- b) Leaching bed of total: \_\_\_\_\_ lineal metres of \_\_\_\_\_ inch diameter distribution pipe of \_\_\_\_\_  
 (type and product description e.g. PVC or CSA Approved Pipe) laid in \_\_\_\_\_ runs and fed by \_\_\_\_\_ (gravity, pump)
- c) Tertiary System: (Manufacturer) \_\_\_\_\_ (Model) \_\_\_\_\_
- d) Mantle \_\_\_\_\_ Filter Sand \_\_\_\_\_ Stone \_\_\_\_\_
- e) Other details: \_\_\_\_\_
- f) **Location:**

 

**The following work remains to be completed:**

- Finish Grading to Shed Run-off and Divert Water Around Leaching Bed
- Other \_\_\_\_\_

---



---




---

Inspector: \_\_\_\_\_ Date: \_\_\_\_\_

**FINAL INSPECTION – USE PERMIT** Mailed Copies: \_\_\_\_\_ (a) Owner (b) Municipality


Inspector \_\_\_\_\_ Date \_\_\_\_\_  
 Chief Building Official \_\_\_\_\_ Date \_\_\_\_\_

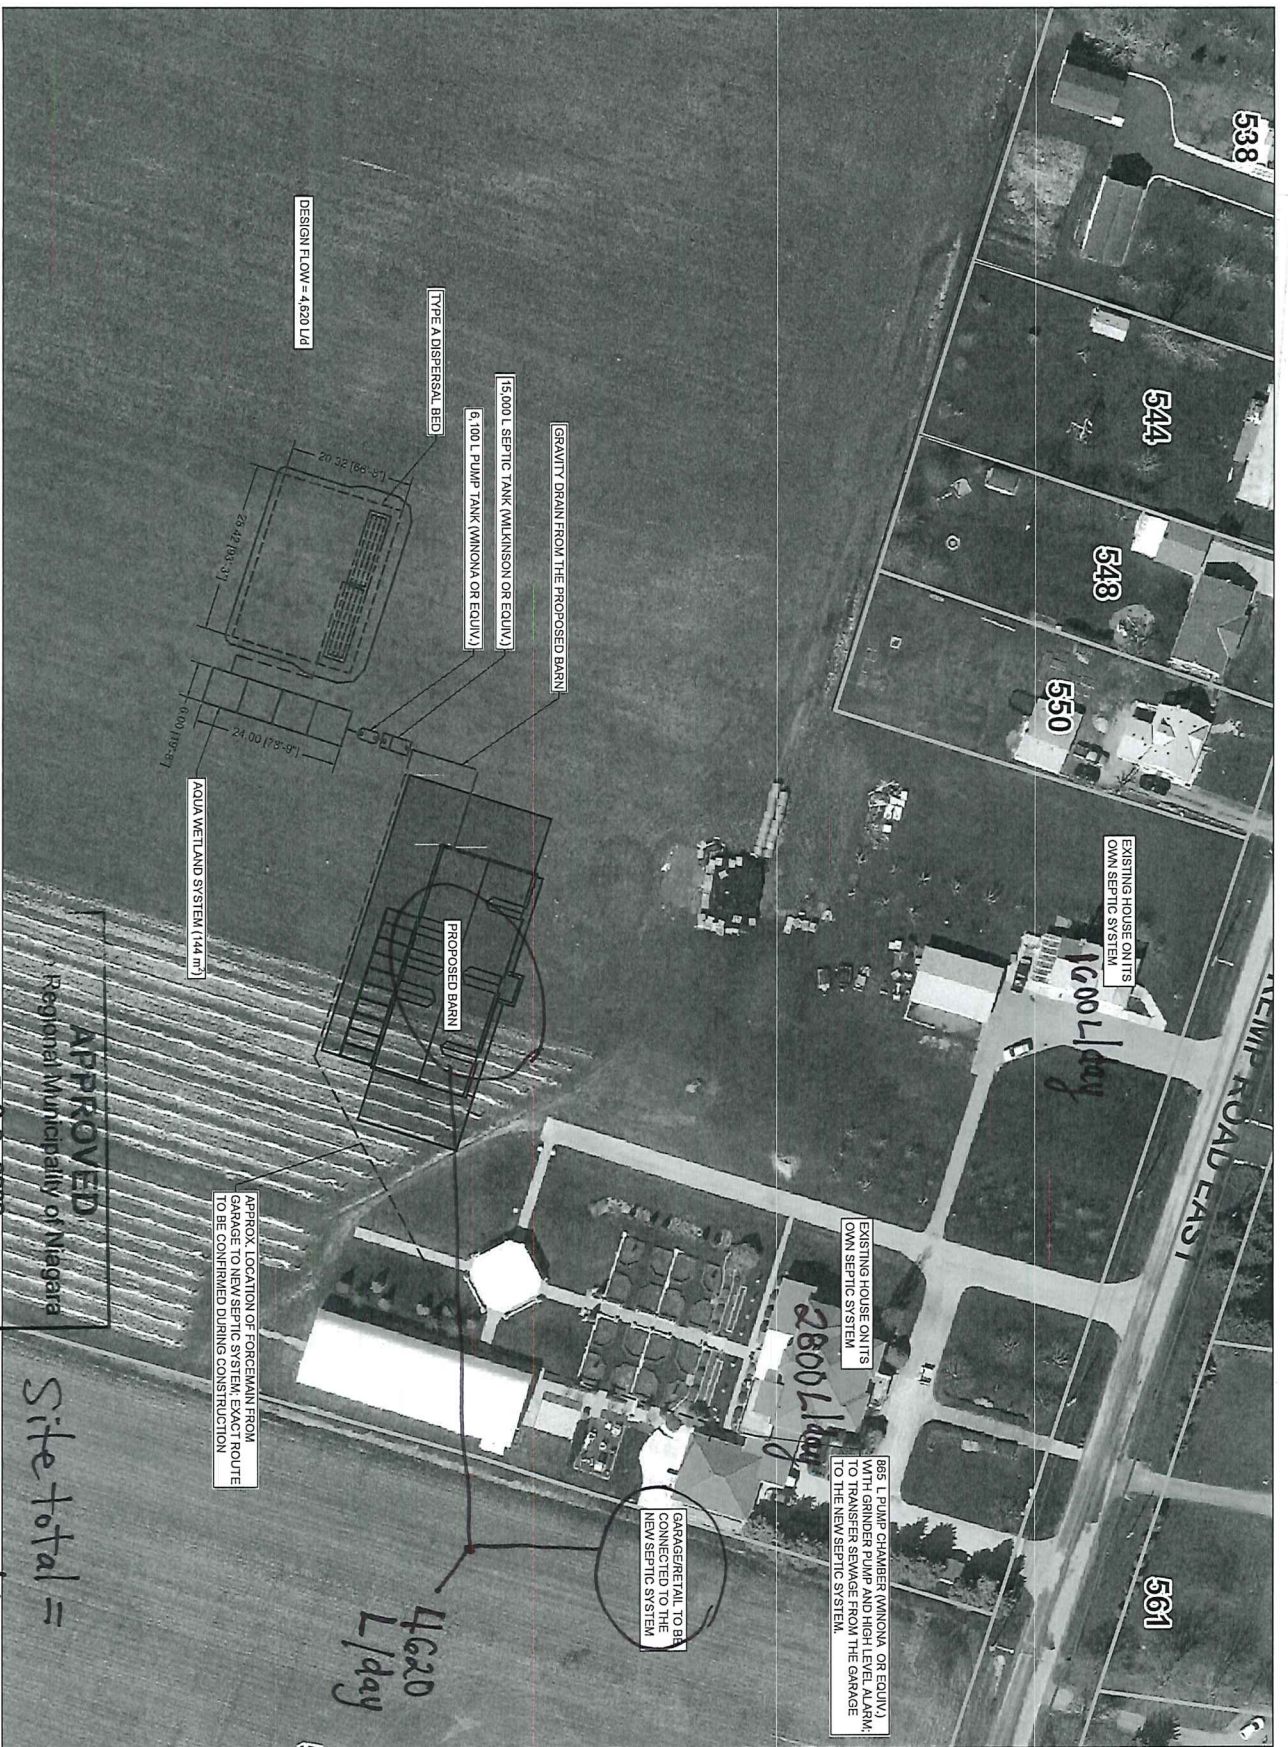

**APPROVED**  
Regional Municipality of Niagara  
**OCT 20 2022**  
**PLANNING AND DEVELOPMENT SERVICES**

Site total =  
9020 L/day

<p>SCALE BAR 0 m 10 m 20 m NORTH</p>	
<p>PROJECT: <b>VILLA BACCHUS</b> 564 Kemp Rd. East, Grimsby, ON DESIGN OF SEWAGE WORKS</p>	
<p><b>Rivercourt</b> Rivercourt Engineering Inc. 4 Beechwood Crescent Toronto ON M6K 2K8 TEL: 647-497-4104 WWW.RIVERCOURT.CA</p>	
<p><b>TREATMENT TECHNOLOGIES</b> THE AQUA WETLAND SYSTEM AQUA Treatment Technologies Inc. 4250 Fry Rd., Campden ON L0R 1G0 905-327-4571 WWW.AQUA-TEC.COM</p>	
<p><b>LICENSED PROFESSIONAL ENGINEER</b> A. J. HELLEBUST Oct. 19, 2022 PROVINCE OF ONTARIO</p>	
<p>DATE: 10/19/2022 DRAWN BY: ER CHECKED BY: AH DATE: 10/19/2022 DATE: 10/15/2020 DRAWN BY: ER CHECKED BY: AH</p>	
<p>REVISIONS: NOTE: EXISTING DESIGN FOR CONSTRUCTION</p>	
<p>DRAWING TITLE: SITE LAYOUT DRAWN BY: ER CHECKED BY: AH</p>	
<p>REVISION: REI-B01</p>	

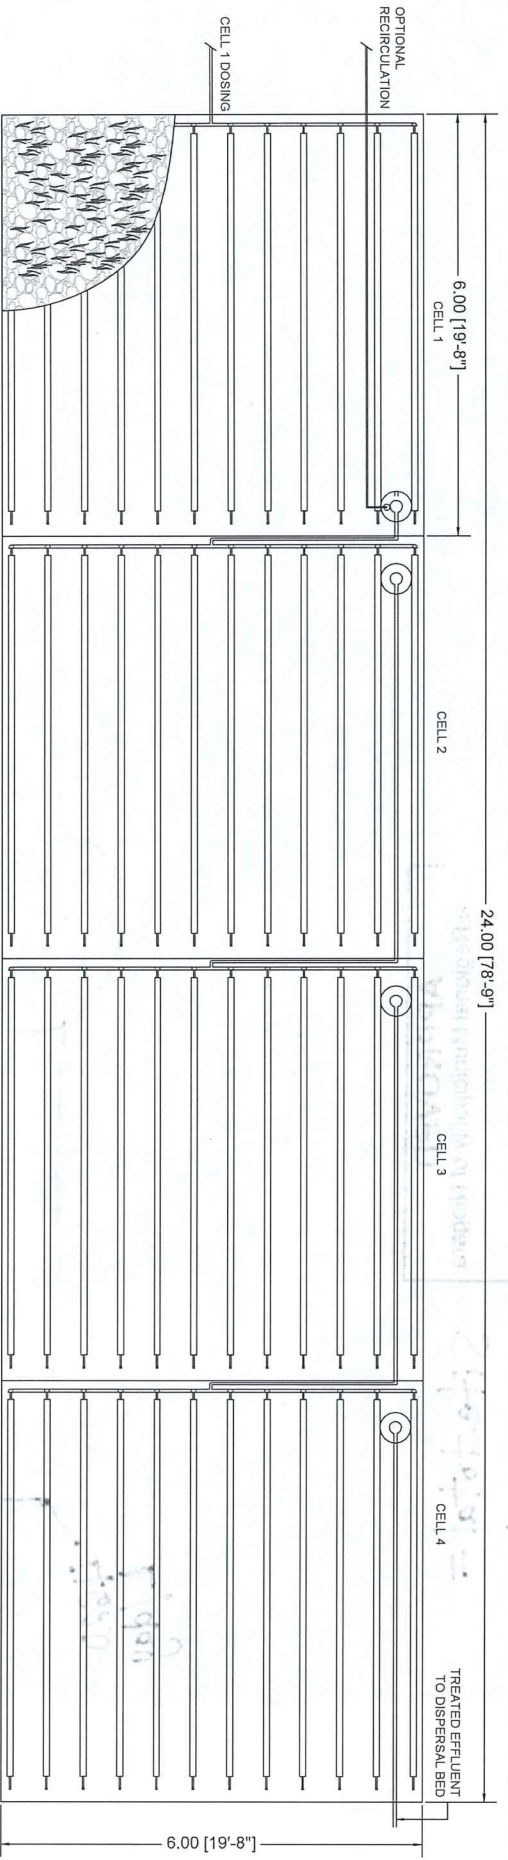


MANIFOLDS COVERED WITH GRAVEL AND PLANTED WITH EMERGENT WETLAND PLANTS

CELL MEDIA:  
 CELL 1 - 0.9 m OF 1/2" CLEAR GRAVEL ON 0.3 m 1/2" CLEAR GRAVEL  
 CELL 2 - 0.9 m OF 1/2" CLEAR GRAVEL ON 0.3 m 1/2" CLEAR GRAVEL  
 CELL 3 - 0.15 m OF 1/2" CLEAR GRAVEL ON 1.05 m OF WOOD SHAVINGS MIXED WITH 1/2" GRAVEL ON TOP OF 0.3 m 1/2" CLEAR GRAVEL  
 CELL 4 - 0.9 m 1/2" CLEAR GRAVEL ON 0.3 m 1/2" CLEAR GRAVEL

2" PIPE FROM PUMP TANK CONNECTS TO 2" MANIFOLD HEADER. LATERALS ARE 3/8" OR 1" PIPE WITH HOLES EVERY 0.6 m

WOODCHIP BIOFILTER CELL (CELL 3) WATER LEVEL IS HIGHER THAN OTHER CELLS TO MAINTAIN A LOW OXYGEN ENVIRONMENT. WOOD SHAVINGS MIXED WITH GRAVEL TO PROVIDE A CARBON SOURCE FOR DENITRIFYING BACTERIA

OPTIONAL RECIRCULATION PUMPS OR BRANCHED PIPES FOR EACH CELL TO ALLOW FOR A PORTION OF THE EFFLUENT TO BE TRANSFERRED TO THE PUMP TANK OR PRECEDING AWW'S CELLS. OTHER RECIRCULATION PATHS ARE OPTIONAL TO OPTIMIZE PERFORMANCE. e.g. RECIRCULATION WITHIN AEROBIC CELLS

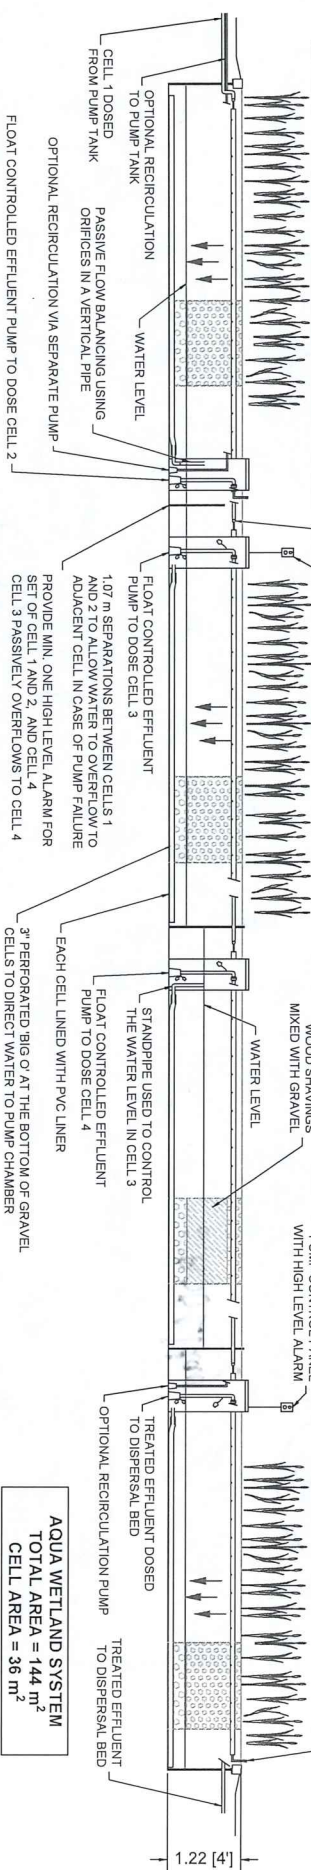

AQUA WETLAND SYSTEM  
 TOTAL AREA = 144 m<sup>2</sup>  
 CELL AREA = 36 m<sup>2</sup>

**APPROVED**  
 The Regional Municipality of Niagara  
 OCT 20 2022  
 PLANNING AND DEVELOPMENT SERVICES

Rivercourt Engineering Inc.  
 4 Beadwood Crescent  
 Toronto ON M4K 2K8  
 Tel. 647-479-4104  
 www.rivercourt.ca

**AQUA TREATMENT TECHNOLOGIES INC.**  
 THE AQUA WETLAND SYSTEM  
 4250 HWY 700-327-4571  
 www.aqua-t.com

PROJECT: **VILLA BACCHUS**  
 564 Kemp Rd. East, Chesham, ON  
 DESIGN OF SEWAGE WORKS



Oct. 19, 2022

NO.	DATE	DESCRIPTION
DATE: 2022 OCT 19  
 DRAWING TITLE: Aqua Wetland System  
 PROJECT: B  
 REVISIONS: REI-B02

**APPROVED**  
The Regional Municipality of Niagara  
**OCT 20 2022**  
**PLANNING AND DEVELOPMENT SERVICES**

Rivercourt Engineering Inc.  
4 Beachville  
Toronto ON M9K 2K8  
Tel. 647-479-4104  
www.rivercourt.ca


**TREATMENT TECHNOLOGIES**  
THE AQUA VITLAND SYSTEM  
AQUA Treatment Technologies Inc.  
4250 Hwy Rd. Campbell ON L0R 1G0  
905-327-4571  
www.aqua-tt.com

PROJECT:  
**VILLA BACCHUS**  
564 Kemp Rd. East, Grimsby, ON  
DESIGN OF SEWAGE WORKS

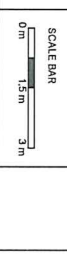

Oct. 19, 2022

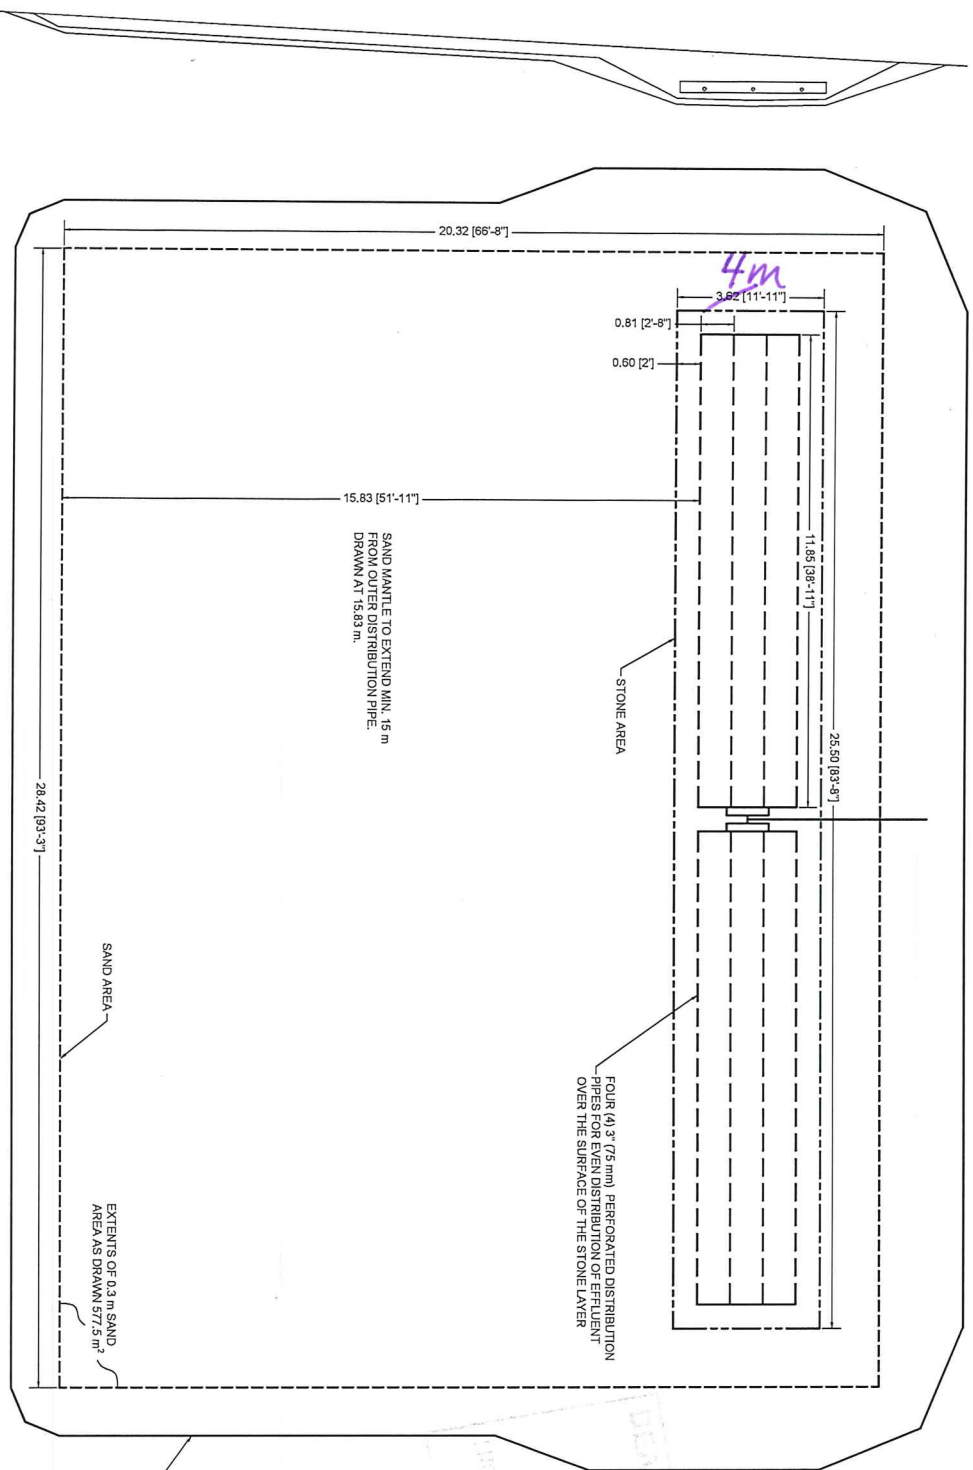

TYPE A DISPERSAL BED  
 DESIGN FLOW = 4,620 L/d  
 SOIL T TIME = 50 min/cm  
 STONE AREA  
 = 92.4 m<sup>2</sup>  
 SAND CONTACT AREA  
 = 4,620 L/d \* 50 min/cm / 400  
 = 577.5 m<sup>2</sup>

THE HEADER LINE AND DISTRIBUTION PIPES WITHIN A LEACHING BED SHALL BE DESIGNED AND CONSTRUCTED SO THAT THEY CAN BE DETECTED BY MEANS OF A 14 GAUGE TW SOLID COPPER LIGHT COLOURED PLASTIC COATED TRACER WIRE OR OTHER MEANS OF SUBSURFACE DETECTION.

APPROX. FOOTPRINT WITH BERMS

EXTENTS OF 0.3 m SAND AREAS DRAWN @ 1:25 m

SAND AREA

STONE AREA

SAND MANTLE TO EXTEND MIN. 15 m FROM OUTER DISTRIBUTION PIPE. DRAWN AT 15.83 m.

REVISION B  
 DRAWING TITLE: Type A Dispersal Bed Overview  
 DRAWING NUMBER: REI-B03




02150000

COVER OVER GRAVEL COMPRISED OF APPROXIMATELY 0.15 m (6-in) LOAMY TOPSOIL (<20 mm) OVER 0.15 m (6-in) SAND FILL 6-10 mm/cm; MOUND TO DIVERT RUNOFF

MIN. 0.6 m SAND UNDER GRAVEL AND IN MANTLE WITH PERC. RATE 6-10 mm/cm UNDER GRAVEL AND WITH NOT MORE THAN 5% FINES PASSING THROUGH A 0.074 mm SIEVE

BERM SLOPES SHOWN AT 1:3. SURFACE TO BE SEEDED WITH GRASS OR EQUIVALENT TO CONTROL EROSION

SAND BASE EXTENDING MIN. 15 m FROM OUTER DISTRIBUTION PIPE. 0.3 m DEPTH SAND WITH PERC. RATE 6-10 mm/cm WITH MIN. 0.1 m LOAMY TOPSOIL OVER.

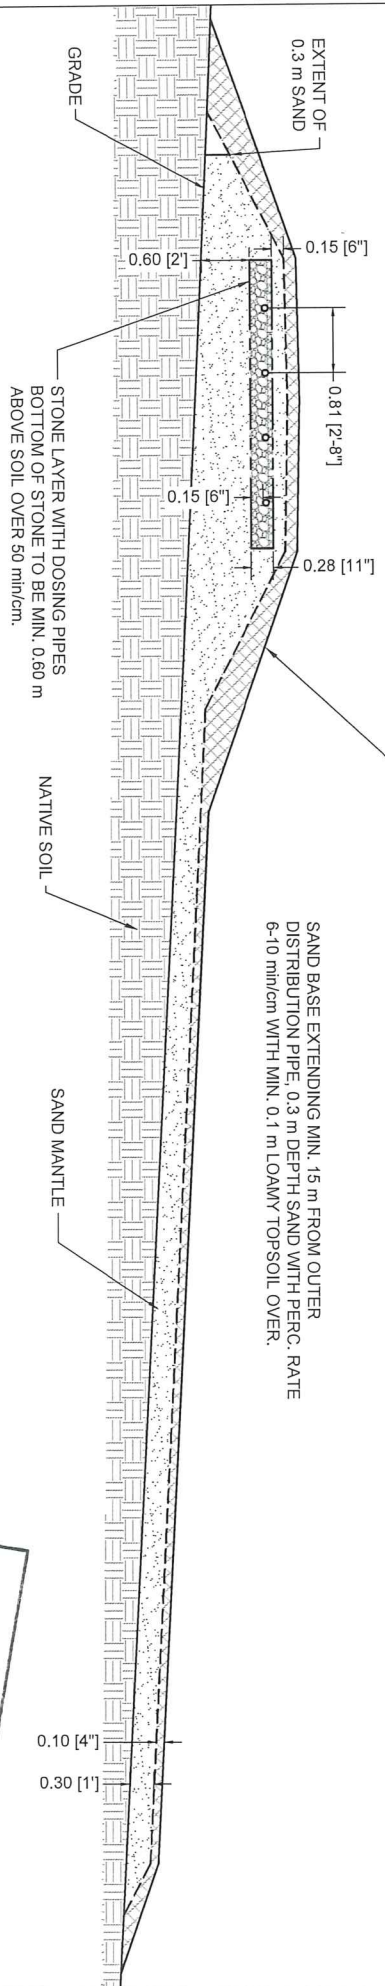


CLEAN GRAVEL PER OBC PART 8, 50 mm OVER AND 150 mm UNDER DISTRIBUTION PIPE.  
GEOTEXTILE BETWEEN GRAVEL AND COVER

PROTECT BED FROM COMPACTION, LOOSEN / SCARIFY SURFACE IF COMPACTED. BED NOT TO BE COVERED BY ANY MATERIAL WITH A HYDRAULIC CONDUCTIVITY BELOW 0.01 m/day.

SHOWN WITH 5% SLOPE ON BOTTOM OF SAND TO MATCH NATIVE SLOPE ON SITE. TOPSOIL CLEARED AND BED PLACED ON SCARIFIED NATIVE SOIL BASE.

**APPROVED**  
The Regional Municipality of Niagara  
**OCT 20 2022**  
**PLANNING AND DEVELOPMENT SERVICES**

<p>Rivercourt Engineering Inc. 4 Beadwood Crescent Tel: 647-479-4104 www.rivercourt.ca</p>	 <p>THE AQUA WEIRLAND SYSTEM AQUA Treatment Technologies Inc. 4250 Fiy Rd, Campbell ON L9R 1G0 905-327-4571 www.aqua-tl.com</p>	<p>PROJECT: <b>VILLA BACCHUS</b> 544 Kemp Rd. East, Ormsby, ON DESIGN OF SEWAGE WORKS</p>	<p>SCALE BAR 0 m 0.5 m 1.5 m</p>	<p>Oct. 19, 2022</p>	<table border="1"> <tr> <td>NO.</td> <td>DATE</td> <td>DESCRIPTION</td> </tr> <tr> <td>1</td> <td>Oct. 19, 2022</td> <td>ISSUED DESIGN - READY FOR NIAGARA REGION REVIEW</td> </tr> <tr> <td>2</td> <td>Oct. 19, 2022</td> <td>ISSUED PERMIT APPLICATION</td> </tr> <tr> <td>3</td> <td>Oct. 19, 2022</td> <td>ISSUED SEWER PERMIT APPLICATION</td> </tr>